

LABOR AND MATERIALS

Copper } Connection ----- \$
 Lead }
 Curb { Cock } ----- in. \$
 { Valve }
 { T. S. & V. }
 Service Box { Short 3/2x4 1/2 } ----- \$
 Old returned { Long 4/2x5 1/2 }
 { Buff. or Rdway }
 Ft. ----- in. { Copper } Pipe at ----- \$
 { Galv Iron }
 { Cast Iron }
 Nipples ----- in. at ----- \$
 Bushings ----- to ----- in. at ----- \$
 Red'g } Couplings ----- to ----- in. at ----- \$
 Inc'g }
 Union ----- in. at ----- \$
 Meter ----- in. at ----- \$
 Lead Joints at ----- \$
 Leadite Joints at ----- \$
 Hrs. Foreman at ----- \$
 Hrs. Chauffeur at ----- \$
 Hrs. Tapper at ----- \$
 Hrs. Labor at ----- \$
 Hrs. Labor at ----- \$
 Hrs. Compressor at ----- \$
 Compensation Ins. ----- \$
 Trucking ----- \$
 Builders Use of Water ----- \$
 ----- \$
 ----- \$
Stevens


St. Pt. Ave. No. 8

Name of Owner

TAX ID # 309.7-6-18

Labor and Mat'l. Report

1914

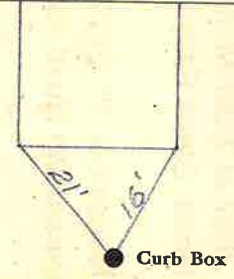

Main Elev. of Main at tap
 Gate at ● Gate at ●

● Curb Box