


**Labor and Materials**

.....	Copper } Connection.....	3	\$ 1.48
.....	Lead } .....		
.....	Curb { Cock Valve } .....	in	\$ 1.79
.....	{ T.S.&V. } .....		
.....	Service Box { Short 3 1/4 x 4 1/2 } .....		\$ 1.30
.....	Old returned { Long 4 1/2 x 5 1/2 } .....		
.....	{ Buff or Rawls } .....		
24	Ft. .... in. { Copper } Pipe at	3/4	\$ 3.78
.....	{ Galv. Iron } .....		
.....	{ Cast Iron } .....		
.....	Nipples ..... in. at		\$
.....	Bushings ..... to ..... in. at		\$
.....	Red'g } Couplings..... to ..... in. at		\$
.....	Inc'g } .....		
.....	Union..... in. at		\$
.....	Meter..... in. at		\$
.....	Lbs. Br. Stone at		\$
.....	Lbs. Sand at		\$
.....	Bags Cement at		\$
.....	Paving Brick { Mack } at		\$
.....	{ Red } .....		
.....	{ Asphalt } .....		
.....	Lead Joints at		\$
.....	Leadite Joints at		\$
3	Hrs. Foreman at		\$ 1.88
15	Hrs. Common Labor at		\$ 6.75
.....	Hrs. Common Labor at		\$
.....	Hrs. Mason at		\$
.....	Hrs. Masons Helper at		\$
.....	Hrs. Compressor at		\$
.....	Compensation Ins		\$ .26
.....	Trucking		\$ 1.00
.....	Builders Use of Water Patch		\$ 5.00
Total			\$ 23.24

5 32-9  
**Labor and Material Report** May 28 1922

9 Stevens St

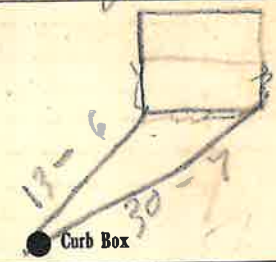

4 Main Elev. of Main at tap 5 1/2

Gate at 3/4 copper 21' to main Gate at

● Curb Box

TAX ID # 309.7-5-4

OK 2/11/20