

LABOR AND MATERIALS


Copper	} Connection	_____	\$ _____	
Lead				
Curb	} Cock Valve T.S. & V. }	_____ in.	\$ _____	
Service box		} Short 3½ x 4½ Long 4½ x 5½ Buff or Rdway }	_____	\$ _____
Old returned				
10 Ft. ¾ in.	} Copper C.I. C.I. }	Pipe at _____	\$ _____	
Nipples	in. at _____	\$ _____		
Bushings	to _____ in. at _____	\$ _____		
Red'g Inc'g	} Coupl'gs	to _____ in. at _____	\$ _____	
Union		in. at _____	\$ _____	
Meter	in. at _____	\$ _____		
Lead Joints	at _____	\$ _____		
Compound Joints	at _____	\$ _____		
Maintenance Foreman	_____	\$ _____		
Hrs. Water Maint. Man-1	at _____	\$ _____		
Hrs. Water Maint. Man-2	at _____	\$ _____		
Hrs. Garage Foreman	at _____	\$ _____		
Hrs. Labor	at _____	\$ _____		
Hrs. Compressor	at _____	\$ _____		
Compensation Ins. at \$ _____	per C _____	\$ _____		
Trucking	_____	\$ _____		
Pav't Patch	_____	\$ _____		
	_____	\$ _____		
	_____	\$ _____		
O'head	_____	\$ _____		
	_____	\$ _____		

St. _____
Pl. _____
Ave. No. 10

Stevens
Name of Owner _____

TAX ID # 309.7-10-19

Labor and Mat'l. Report July 13 1984

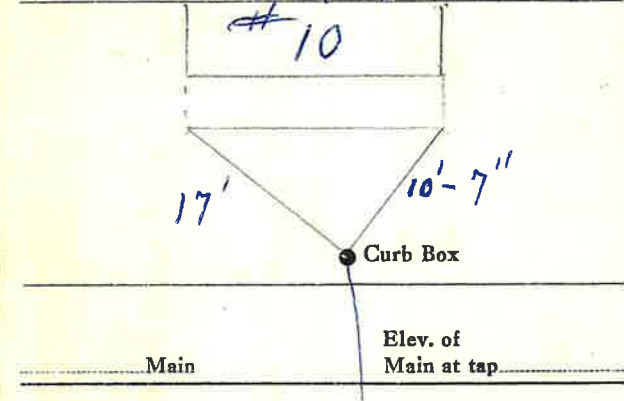

Gate at • • Gate at

¾" Copper 10' to main

Tap By Lynch & Willett • Curb Box