


Labor and Materials

1	Copper	Connection	7	\$ 2.60
1	Lead		4	
1	Curb	Cock Valve	2	\$ 2.27
		P.S.V.	4	
1	Service Box	Short 3 1/2 x 4 1/2		\$ 1.36
	Old returned	Long 4 1/2 x 5 1/2		
		Def. or Repair		
27	Ft.	Copper	8	\$ 4.86
	in.	Galv. Iron	4	
		Cast Iron		
	Nipples	in. at		\$
	Bushings	to in. at		\$
	Red'g	Couplings	to in. at	\$
	Inc'g			
	Union	in. at		\$
	Meter	in. at		\$
	Lbs. Br. Stone	at		\$
	Lbs. Sand	at		\$
	Bags Cement	at		\$
	Paving Brick	Mack	at	\$
		Red		
		Asphalt		
	Lead Joints	at		\$
	Leadite Joints	at		\$
4	Hrs. Foreman	at		\$ 7.50
16	Hrs. Common Labor	at		\$ 1.20
	Hrs. Common Labor	at		\$
	Hrs. Mason	at		\$
	Hrs. Masons Helper	at		\$
	Hrs. Compressor	at		\$
	Compensation Ins			\$ 30
	Trucking			\$ 1 -
	Builders Use of Water	Patch		\$ 5 -
Total \$				27.11

5 27-28
Labor and Material Report *April* 26 1932

2 Stewart Ave

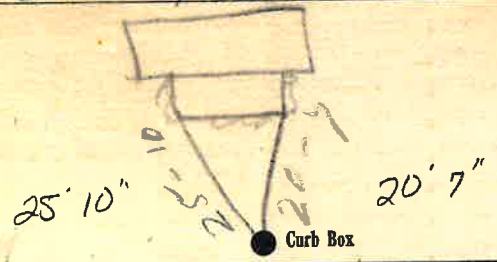

6 Main Elev. of Main at tap 4 1/2

Gate at 3/4" Copper 27' to Gate at MAIN

● Curb Box

old shut. off.
 TAX ID # 309.16-1-4

O.K. 9/105.