


Labor and Materials

1	Copper } Connection	2	\$ 2.60
1	Curb } Cock } Valve } T.S. & V. }	3	\$ 2.27
	Service Box } Short 3/4 x 1/2 } Iron } Buff. or R.dway }	1	\$ 1.35
28	Ft. } in. } Copper } Galv. Iron } Cast Iron } Pipe at		\$ 5.04
	Nipples		\$
1	Bushings	3 to 3/4 in. at	\$ 1.0
	Red'g } Inc'g } Couplings	3 to 4 in. at	\$
	Union	in. at	\$
	Meter	in. at	\$
	Lbs. Br. Stone at		\$
	Lbs. Sand at		\$
	Bags Cement at		\$
	Paving Brick } Mack } Red } Asphalt }	at	\$
	Lead Joints at		\$
	Leadite Joints at		\$
3	Hrs. Foreman at		\$ 1.85
16	Hrs. Common Labor at		\$ 7.20
	Hrs. Common Labor at		\$
	Hrs. Mason at		\$
	Hrs. Mason's Helper at		\$
	Hrs. Compressor at		\$
	Compensation Ins		\$.28
	Trucking		\$ 1.-
	Builders' Use of Water	Patch	\$ 5.-
	Total		\$ 26.75

31-100
Labor and Material Report Aug 26, 1931

16 Stevenson

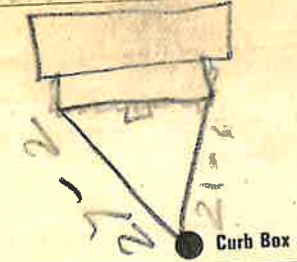

6 Main Elev of Main at tap 52

Gate at ● Gate at

3/4" Copper 28' to MAIN

● Curb Box

old Tap shut off
 at Main

TAX ID# 309.15-3-1