


Labor and Materials

Copper } Connection.....	\$
Lead }	\$
Curb { Cock }	\$
{ Valve }	\$
{ T. S. & V. }	\$
Service Box { Short 3½ x 4½ }	\$
Old returned { Long 4½ x 5½ }	\$
{ Buff. or Rdway }	\$
Ft. in. { Copper } Pipe at.....	\$
{ Galv. Iron }	\$
{ Cast Iron }	\$
Nipples..... in. at.....	\$
Bushings..... to..... in. at.....	\$
Red'g } Couplings..... to..... in. at.....	\$
Inc'g }	\$
Union..... in. at.....	\$
Meter..... in. at.....	\$
Lbs. Br. Stone at.....	\$
Lbs. Sand at.....	\$
Bags Cement at.....	\$
Paving Brick { Mack } at.....	\$
{ Red }	\$
{ Asphalt }	\$
Lead Joints at.....	\$
Leadite Joints at.....	\$
Hrs. Foreman at.....	\$
Hrs. Common Labor at.....	\$
Hrs. Common Labor at.....	\$
Hrs. Mason at.....	\$
Hrs. Mason's Helper at.....	\$
Hrs. Compressor at.....	\$
Compensation Ins.....	\$
Trucking.....	\$
Builders' Use of Water.....	\$
Total \$.....	

20 STEWART AVE

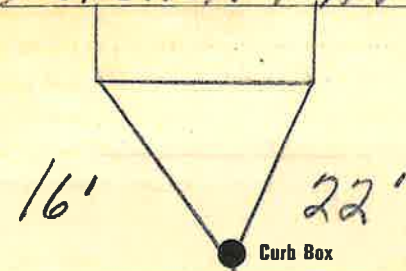

Main

Elev. of Main at tap

Gate at ●

● Gate at

● Curb Box

TAX ID# 309.15-3-3