


Labor and Materials

✓	Copper	Connection	\$ 3.20
✓	Lead			
1	Curb	{ Cock Valve } T.S. & V. in.	\$ 1.00
1	Service Box	{ Short 3 1/2 x 4 1/2 } Old returned { Long 4 x 6 } { Bull. or Rdway }	\$ 1.20
9	Ft.	in. { Copper } { Galv. Iron } { Cast Iron }	Pipe at C. 22	\$ 1.98
	Nipples in. at		\$
	Bushings to in. at		\$
	Red'g Inc'g	Couplings to in. at	\$
	Union in. at		\$
	Meter in. at		\$
	Lbs. Br. Stone	at		\$
	Lbs. Sand	at		\$
	Bags Cement	at		\$
	Paving Brick	{ Mack } { Red } { Asphalt }	at	\$
	Lead Joints	at		\$
	Leadite Joints	at		\$
2	Hrs. Foreman	at	62.5	\$ 1.25
5	Hrs. Common Labor	at	<i>L. D. Smith</i>	\$ 2.50
	Hrs. Common Labor	at		\$
	Hrs. Mason	at		\$
	Hrs. Mason's Helper	at		\$
	Hrs. Compressor	at		\$
	Compensation Ins.			\$ 11
	Trucking			\$ 1.00
	Builders' Use of Water			\$
Total				\$ 1.234

76-1

Labor and Material Report *April 21* 1926

21 Stewart Ave

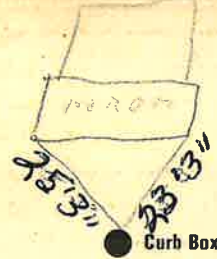

6 Main

Elev. of Main at tap 5

Gate at ●

3/4" copper 9' to MAIN

● Gate at

● Curb Box

TAX ID # 309.11-15-15