


Labor and Materials

1	Copper	Connection	3/4	\$ 2.60
1	Curb	Cock Valve T.S. & V.	3/4	\$ 2.30
1	Service Box	Short 3/4x4 1/2	3/4	\$ 1.40
	Old returned	Long 4 1/2x6 1/2		
8	Pt.	Copper Cast Iron	Pipe at	\$ 2.12
	Nipples	in. at		\$
	Bushings	to in. at		\$
	Red'g Inc'g	Couplings	to in. at	\$
	Union	in. at		\$
	Meter	in. at		\$
	Lbs. Br. Stone	at		\$
	Lbs. Sand	at		\$
	Bags Cement	at		\$
	Paving Brick	Mack Red Asphalt	at	\$
	Lead Joints	at		\$
	Leadite Joints	at		\$
2	Hrs. Foreman	at		\$ 1.25
4	Hrs. Common Labor	at Tap		\$ 2.00
	Hrs. Common Labor	at		\$
	Hrs. Mason	at		\$
	Hrs. Mason's Helper	at		\$
	Hrs. Compressor	at		\$
	Compensation Ins			\$ 0.9
	Trucking			\$ 1.00
	Builders' Use of Water	Patch		\$ 5.00

Total \$ 17.76

29-107 Labor and Material Report 7/8/1924

23 Street Area

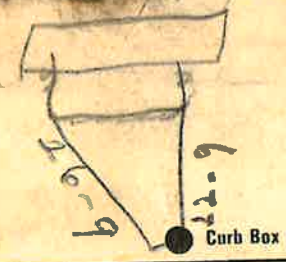

6 Main Elev of Main at tap 5
 Gate at 3/4" Copper 8' to MAIN Gate at

● Curb Box

New House
 To Hoyt