

Labor and Materials


Copper } Connection.....	2	\$ 2.60
Lead }	2	
Curb } Cock }	3	\$ 2.27
} Valve }		
} T. S. & V. }		
Service Box } Short 3/4x4 1/2 }		\$ 1.38
Old returned } Long 1 1/2x2 1/2 }		
} Butt or Rdway }		
27 Ft. in. } Copper } Pipe at.....	3	\$ 4.86
} Galv. Iron }		
} Cast Iron }		
Nipples..... in. at.....		\$
Bushings..... to..... in. at.....		\$
Red'g } Couplings..... to..... in. at.....		\$
Inc'g }		
Union..... in. at.....		\$
Meter..... in. at.....		\$
Lbs. Br. Stone at.....		\$
Lbs. Sand at.....		\$
Bags Cement at.....		\$
Paving Brick } Mack } at.....		\$
} Red }		
} Asphalt }		
Lead Joints at.....		\$
Leadite Joints at.....		\$
2 Hrs. Foreman at.....		\$ 1.25
16 Hrs. Common Labor at.....		\$ 7.20
Hrs. Common Labor at.....		\$
Hrs. Mason at.....		\$
Hrs. Mason's Helper at.....		\$
Hrs. Compressor at.....		\$
Compensation Ins.....		\$ 26
Trucking.....		\$ 1.-
Builders' Use of Water.....		\$ 5.-
Total \$		25.82

31-22

Labor and Material Report

April 20, 1931

4 Stewart Ave

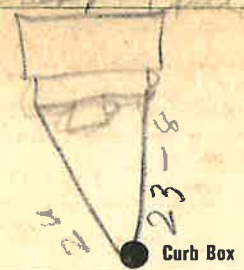

6 Main

Elev of Main at tap 5

Gate at ● 3/4" Copper 27' to MAIN ● Gate at

● Curb Box

Old tap disconnected

TAX ID # 309.16-1-5