


LABOR AND MATERIALS

1	Copper Lead	Connection	3/4"	\$ 2.41
1	Curb	Cock Valve T.S. & V.	3/4 in.	\$ 3.41
1	Service box Old returned	Short 3 1/2 x 4 1/2 Long 4 1/2 x 5 1/2 Buff or Rdway		\$ 4.18
27	Ft. 3/4 in.	Copper G.I. C.I. Pipe at	40	\$ 10.80
	Nipples	in. at		\$
	Bushings	to in. at		\$
	Red'g Inc'g	Coupl'gs to in. at		\$
	Union	in. at		\$
	Meter	in. at		\$
	Lead Joints	at		\$
	Compound Joints	at		\$
	Maintenance Foreman			\$
	Hrs. Water Maint. Man-1	at		\$
	Hrs. Water Maint. Man-2	at		\$
2	Hrs. Garage Foreman	at 1.59		\$ 3.18
18	Hrs. Labor	at 1.13		\$ 20.34
	Hrs. Compressor	at		\$
	Compensation Ins.	at \$3861 per C.		\$ 91
	Trucking			\$ 1.50
	Pav't Patch			\$ 16.20
	Tap made Oct 20-54			\$
	By Laccan			\$
	O'head			\$
				\$ 62.93

Stewart St. Pl. Ave. No. 24

Name of Owner La Point

Labor and Mat'l. Report Oct 20 19 54

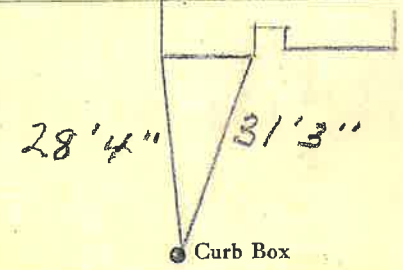

6" Main Elev. of Main at tap 4 1/2"

Gate at • Gate at

3/4" Copper 27' to main

• Curb Box

TAX ID# 309.15-3-4