


LABOR AND MATERIALS

1	Copper	} Connection	3/4"	\$
	Lead			
1	Curb	} Cock Valve T.S. & V.	3/4 in.	\$
1	Service box	} Short 3 1/2 x 4 1/2		\$
	Old returned			
9	Ft. 3/4 in.	} Copper G.I. C.I.	} Pipe at	\$
	Nipples	in. at	\$	
	Bushings	to in. at	\$	
	Red'g	} Coupl'gs	to in. at	\$
	Inc'g			
	Union	in. at	\$	
	Meter	in. at	\$	
	Lead Joints	at	\$	
	Compound Joints	at	\$	
	Maintenance Foreman		\$	
	Hrs. Water Maint. Man	1 at	\$	
	Hrs. Water Maint. Man	2 at	\$	
	Hrs. Garage Foreman	at	\$	
	Hrs. Labor	at	\$	
	Hrs. Compressor	at	\$	
	Compensation Ins.	at \$ per C	\$	
	Trucking		\$	
	Pav't Patch		\$	
	Top by Miller & Co		\$	
	6-24-65		\$	
	O'head		\$	
			\$	

Stewart Ave. No. 25

Name of Owner  
Dorothy Dickinson

Labor and Mat'l. Report June 24 1965

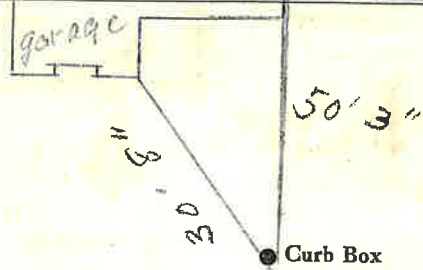

6" Main Elev. of Main at tap 5'

Gate at • Gate at

3/4" Copper 9' to main

• Curb Box

TAX ID # 309.11-15-13