


### Labor and Materials

1	Lead Connection	3/4"	.....	\$.
1	Curb Cock		.....	\$.
1	Service Box	{ Short 3 1/2 x 4 1/2	.....	\$.
	Old returned	{ Long 4 1/2 x 5 1/2	.....	\$.
		{ Buffalo	.....	\$.
27	Ft. .... in. G. I. Pipe at		.....	\$.
	Nipples	..... in. at	.....	\$.
	Bushings	..... to ..... in. at	.....	\$.
	Red'g Coup	..... to ..... in. at	.....	\$.
	Inc'g Coup	..... to ..... in. at	.....	\$.
	Union	..... in. at	.....	\$.
	Meter	..... in. at	.....	\$.
	Cu. Yds. Br. Stone at		.....	\$.
	Cu. Yds. Sand at		.....	\$.
	Bags Cement at		.....	\$.
	Paving Brick	{ Mack	} at	\$.
		{ Red		
		{ Asphalt		
4	Hrs. Foreman at		.....	\$.
3	Hrs. Common Labor at		.....	\$.
	Hrs. Mason at		.....	\$.
	Hrs.	..... at	.....	\$.
	Hrs.	..... at	.....	\$.
Gas	Builders' Use of Water		.....	\$.
		..... at	.....	\$.
		..... at	.....	\$.
		..... at	.....	\$.
		..... at	.....	\$.
Total				\$ 18.17

Labor and Material Report Apr 22 1920

3/4" tap at 34 Steward Ave

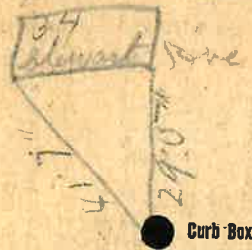

6' Main

Elev. of Main at tap 74'

Gate at ● LEAD 27' to MAIN ● Gate at

● Curb Box

TAX ID # 309.15-3-9