


Labor and Materials

1	Copper	Connection	?	\$ 2.60
1	Curb	Cock Valve	in. 3/4	\$ 2.30
1	Service Box	Short 3/4x4 1/2		\$ 1.40
	Old returned	Long 1 1/2x5 1/2		
		Buff. or Rwy		
7	Pt.	Copper	Pipe at 3/4	\$ 1.86
		Galv. Iron		
		Cast Iron		
	Nipples	in. at		\$
	Bushings	to in. at		\$
	Red'g Inc'g	Couplings	to in. at	\$
	Union	in. at		\$
	Meter	in. at		\$
	Lbs. Br. Stone	at		\$
	Lbs. Sand	at		\$
	Bags Cement	at		\$
	Paving Brick	Mack Red Asphalt	at	\$
	Lead Joints	at		\$
	Leadite Joints	at		\$
4	Hrs. Foreman	at		\$ 2.50
2	Hrs. Common Labor	at		\$.81
	Hrs. Common Labor	at		\$
	Hrs. Mason	at		\$
	Hrs. Mason's Helper	at		\$
	Hrs. Compressor	at		\$
	Compensation Ins.			\$.09
	Trucking			\$ 1.00
	Builders' Use of Water	Patch		\$ 5.00
Total				\$ 17.56

29-47
Labor and Material Report

May 7 1929

5 Street Avenue

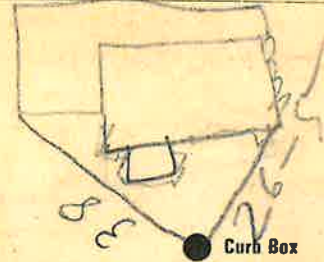

6 Main

Elev of Main at tap 4

Gate at

3/4" Copper

7' to main

Gate at

● Curb Box

OLD TAP COMES IN
FROM 5th St.

TAX ID # 309.12-15-16