

### Labor and Materials

1	Copper Lead-Connection	3/4"	\$	1.46
1	Curb	Cock Valve T-S. & V. } 3/4" in	\$	1.93
1	Service Box Old returned	Short 3 1/2 x 4 1/2 Long 4 1/2 x 5 1/2 Buff. or Rdway } Copper Galv-Iron Cast-Iron } Pipe at 22	\$	1.77
2.7	Ft. 3/4" in.		\$	5.94
	Nipples	in. at	\$	
	Bushings	to in. at	\$	
	Red'g Inc'g	Conplings to in. at	\$	
	Union	in. at	\$	
	Meter	in. at	\$	
	Lead Joints	at	\$	
	Leadite Joints	at	\$	
	Hrs. Foreman	at	\$	
3	Hrs. Chauffeur	at 6 1/2	\$	1.88
8	Hrs. Tapper	at 6 1/2	\$	5.00
8	Hrs. Labor	at 45	\$	3.60
	Hrs. Labor	at	\$	10.42
2	Hrs. Compressor	at 8 1/2	\$	1.75
	Compensation Ins.		\$	.32
	Trucking		\$	1.02
	Builders Use of Water	Patch (Jewer)	\$	2.50
			\$	
			\$	
	Tap made by Paris		\$	
			\$	27.15


8 0-1937

St. \_\_\_\_\_  
Pl. \_\_\_\_\_  
Ave. No. 6

Name of Owner

Bannon

Labor and Mat'l. Report June 14 1937

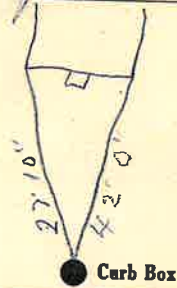

● Curb Box

6" Main

Elev. of Main at tap 4 1/2

● Gate at

3/4" Copper

● Gate at

27' to MAIN

● Curb Box

New House

✶

TAX ID# 309.16-1-6