

LABOR AND MATERIALS

1 Copper Connection ^{3/4"}	\$ 2.76
1 Lead Cock ^{3/4}	\$ 3.49
1 Curb Valve ^{3/4} in. T. S. & V.	\$.
Service box Short 3 1/2 X 4 1/2 } Old returned Long 4 1/2 X 5 1/2 } Buff or Rdway }	\$ 4.74
26 Ft. ^{3/4} in. Copper Pipe at 38.....	\$ 9.88
C. I.	\$.
Nipples..... in. at.....	\$.
Bushings..... to..... in. at.....	\$.
Red'g Inc'g Coupl'gs..... to..... in. at.....	\$.
Union..... in. at.....	\$.
Meter..... in. at.....	\$.
Lead Joints at.....	\$.
Compound Joints at.....	\$.
6 Hrs. Water Maint. Man-1 at.....	\$ 9.54
6 Hrs. Water Maint. Man-2 at.....	\$ 1.13
6 Hrs. Labor-..... at.....	\$ 6.78
Hrs. Labor-..... at.....	\$.
Hrs. Compressor at.....	\$.
Compensation Ins. at \$ 4.406 per C.....	\$ 72
Trucking.....	\$ 1.00
Pay't Patch.....	\$ 3.39
Tap June 3 1953 by Larcen & George.....	\$.
O'head.....	\$.
<i>3891</i>	\$ 52.30


total cost

71-53

St. Stewart
Pl: 8
Ave. No. 8

Name of Owner Gilbert

Labor and Mat'l. Report June 3 1953

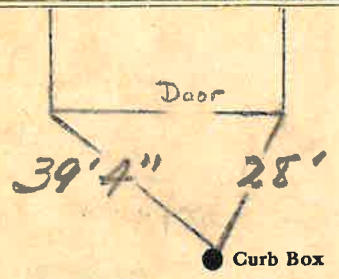

6" Main Elev. of Main at tap 5'

Gate at ● Gate at ●

3/4" Copper 26' to main

TAX ID# 309.16-1-7