

LABOR AND MATERIALS

Copper } Connection _____ \$
 Lead }
 Curb } Cock } _____ in. \$
 } Valve }
 } T.S. & V. }
 Service box { Short 3-1/2 x 4-1/2 } _____ \$
 Old returned { Long 4-1/2 x 5-1/2 }
 29'6" Ft. 3/4 in. { Copper } Pipe at _____ \$
 }
 }
 Nipples _____ in. at _____ \$
 Bushings _____ to _____ in. at _____ \$
 Red'g _____
 Inc'g _____
 Union _____ in. at _____ \$
 Meter _____ in. at _____ \$
 _____ \$
 Compound Joints at _____ \$
 Maintenance Foreman _____ \$
 Hrs. Water Maint. Man - 1 at _____ \$
 Hrs. Water Maint. Man - 2 at _____ \$
 Hrs. Garage Foreman _____ at _____ \$
 Hrs. Labor _____ at _____ \$
 Hrs. Compressor at _____ \$
 _____ \$
 Trucking _____ \$
 Pav't Patch _____ \$
 _____ \$
 _____ \$

STEWART

St. Ave. No. 12

Name of Owner

Labor and Mat'l. Report

APR. 17, 1984

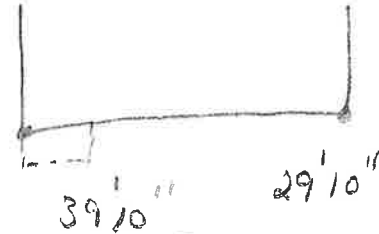

● Curb Box

_____ Main

Elev. of Main at tap _____

Gate at ●

● Gate at

3/4" Copper 29'6" to main

● Curb Box

TAX ID # 309.16-1-9