


Labor and Materials

Copper	Connection	9	\$ 2.60
Head			
Curb	Cock Valve	in.	\$ 2.30
	T. S. & V.	3	
Service Box	Short 3/4x1 1/2		\$ 1.50
Oil returned	Long 4 1/2x5 1/2		
	Full or Rdway		
8 Ft.	Copper	Pipe at	\$ 2.12
	Galv. Iron		
	Cast Iron		
Nipples	in. at		\$
Bushings	to in. at		\$
Red'g	Couplings	to in. at	\$
Inc'g			
Union	in. at		\$
Meter	in. at		\$
Lbs. Br. Stone	at		\$
Lbs. Sand	at		\$
Bags Cement	at		\$
Paving Brick	Mack	at	\$
	Red		
	Asphalt		
Lead Joints	at		\$
Leadite Joints	at		\$
3 Hrs.	Foreman at		\$ 1.80
6 Hrs.	Common Labor at		\$ 2.44
Hrs.	Common Labor at		\$
Hrs.	Mason at		\$
Hrs.	Mason's Helper at		\$
Hrs.	Compressor at		\$
Compensation Ins			\$ 1.11
Trucking			\$ 1.00
Builders' Use of Water	Patch		\$ 5.00
Total			\$ 18.95

Labor and Material Report

April 1 1929

1/2 Stoddard Ave

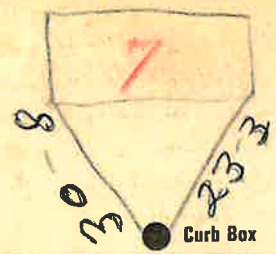

6 Main

Elev of Main at tap 5.2

Gate at 3/4" Copper Gate at 8' to MAIN

● Curb Box

New Bldg.

TAX ID# 302.16-8-4