

**Labor and Materials**

1	Copper } Connection $\frac{3}{4}$ "	\$ 3.20
1	Curb } Cock } $\frac{3}{4}$ " in.	\$ 1.00
	} Valve } T. S. & V.	
	Service Box } Short 3" x 4"	\$ 1.30
	Old returned } Long 4" x 5"	
	} Buff. or Rdway.	
13	Ft. $\frac{3}{4}$ " in. } Copper } Pipe at	\$ 2.86
	} Galv. Iron }	
	} Cast-iron }	
	Nipples..... in. at.....	\$
1	Bushings $\frac{3}{4}$ " to $\frac{1}{4}$ " in. at.....	\$ .08
	Red'g } Couplings..... to..... in. at.....	\$
	Inc'g }	
	Union..... in. at.....	\$
	Meter..... in. at.....	\$
	Lbs. Br. Stone at.....	\$
	Lbs. Sand at.....	\$
	Bags Cement at.....	\$
	Paving Brick } Mack } at.....	\$
	} Red }	
	} Asphalt }	
	Lead Joints at.....	\$
	Leadite Joints at.....	\$
2	Hrs. Foreman at..... 62.5	\$ 1.25
4	Hrs. Common Labor at..... 50	\$ 2.00
8	Hrs. Common Labor at..... 70.8	\$ 3.25
	Hrs. Mason at.....	\$
	Hrs. Mason's Helper at.....	\$
	Hrs. Compressor at.....	\$
	Compensation Ins.....	\$ 18
	Trucking.....	\$ 1.00
	Builders' Use of Water.....	\$
Total		\$ 16.12

76-159


23

**Labor and Material Report**

Sept 30 1926

11 STODDARD AVE

23

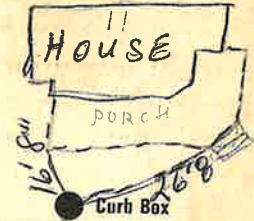

11 Main

Elev. of Main at tap 6

Gate at

$\frac{3}{4}$ " copper

13' to MAIN

Gate at

● Curb Box

TAX ID # 302.12-19-5