

LABOR AND MATERIALS

1	Copper	Connection	3/4	\$ 1.80
1	Curb	Cock Valve T. S. & V.	3/4 in.	\$ 1.96
1	Service Box	Old returned	Short 3 1/2 x 4 3/4 Long 4 1/2 x 5 1/2 Buffer Rdway	\$ 1.82
29	Ft.	3/4 in.	Copper Galv. Iron Cast Iron	Pipe at 19 \$ 5.51
	Nipples	in. at		\$
	Bushings	to in. at		\$
	Red'g Inc'g	Couplings to in. at		\$
	Union	in. at		\$
	Meter	in. at		\$
	Lead Joints	at		\$
	Leadite Joints	at		\$
	Hrs. Foreman	at		\$
9	Hrs. Chauffeur	at	6.19	\$ 6.19
	Hrs. Tapper	at		\$
8	Hrs. Labor	at	.60	\$ 4.80
	Hrs. Labor	at		\$
	Hrs. Compressor	at		\$
	Compensation Ins.		2.669	\$ 2.669
	Trucking			\$ 1.05
	Builders Use of Water			\$ 17.94
	Taps & Wascinsks			\$
				\$
				\$
				\$
				\$
				\$ 41.31

10-1-44

Standard


St. Pl. Ave. No. 8

Name of Owner

Potter

Labor and Mat'l. Report

June 23 1944

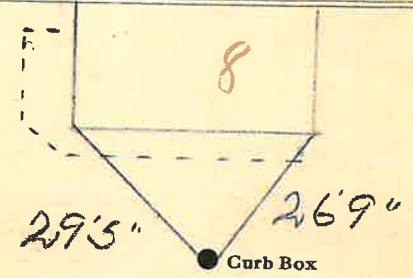

6 Main

Elev. of Main at top 5

Gate at ●

● Gate at

3/4" copper 29' to main

● Curb Box

TAX ID# 302.16-7-1