

Labor and Materials

1	Copper	Connection	3/4"	\$ 1.50
1	Lead			
1	Curb	Cock Valve T.S.&V.	3/4" in	\$ 1.70
1	Service Box	Short 3 1/2 x 4 1/2		\$ 1.44
	Old returned	Long 4 1/2 x 5 1/2		
		Buff. or Rdway		
9	Ft.	3/4" in	Copper Galv. Iron Cast Iron Pipe at	\$ 1.71
	Nipples	in. at		\$
	Bushings	to in. at		\$
	Red'g Inc'g	Couplings	to in. at	\$
	Union	in. at		\$
	Meter	in. at		\$
	Lbs. Br. Stone	at		\$
	Lbs. Sand	at		\$
	Bags Cement	at		\$
	Paving Brick	Mack Red Asphalt	at	\$
	Lead Joints	at		\$
	Leadite Joints	at		\$
6	Hrs. Foreman	F&C	6 1/2 hr	\$ 2.75
7	Hrs. Common Labor	at	50	\$ 3.50
4	Hrs. Common Labor	at	45	\$ 1.80
	Hrs. Mason	at		\$
	Hrs. Masons Helper	at		\$
	Hrs. Compressor	at		\$
	Compensation Ins			\$ 0.33
	Trucking			\$ 2.-
	Bulldozers Use of Water	Part. Patch		\$ 5.-
Total \$				23.73


132 34 9

Labor and Material Report Nov 6

1934

3/4 tap at 1 - Stoddard Ave

9

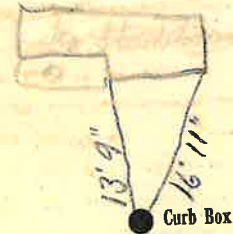

Curb Box

6" Main

Elev. of Main at tap 472.4

Gate at

3/4 Copper

9' to main

Gate at

Curb Box

Old tap to be dug up
Paid for

JWS

TAX ID# 302.16-8-3

VM