

Labor and Materials


1. Copper	}	Connection.....	3	\$ 1.46
Lead			1	
	}	Cock	3	\$ 1.93
		Valve		
Curb		T.-S. & V.		
	}	Short 3½ x 4½	1	\$ 1.77
		Long 4½ x 5½		
Service Box Old returned		Buff. or Rdway		
9 Ft.	}	Copper	22	\$ 1.98
		Galv Iron		
		Cast Iron		
		Pipe at		
Nipples		in. at		
Bushings		to		
Red'g Inc'g		Conplings.....		
Union		in. at		
Meter		in. at		
Lead Joints		at		
Leadite Joints		at		
Hrs. Foreman		at		\$ 3.13
5 Hrs. Chauffeur		at		\$.63
1 Hrs. Tapper		at		\$ 5.85
13 Hrs. Labor		at		\$ 9.61
		Hrs. Labor		
		Hrs. Compressor		\$.30
		Compensation Ins.		\$ 1.00
		Tracking		\$ 5.00
		Builders Use of Water		
Top by Meter \$ 23.05				

110-1937

St. 17
Pl.
Ave. No.

Name of Owner
Don

Labor and Mat'l. Report
Oct 22 1937

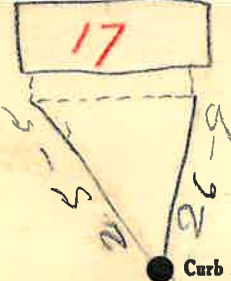

TAX ID# 302.12-19-8

4 Main Elev. of Main at tap.....

Gate at ● Gate at
3/4" Copper 9' to MAIN

● Curb Box

old shut off

NOTE - CURB STOP -
 REVERSE BOX - "OFF" IS
 ON