

LABOR AND MATERIALS

1/	Copper Lead	{ Connection $\frac{3}{4}$	-----	\$ 1.31
1/	Curb	{ Cock Valve T. S. & V. } $\frac{3}{4}$ in.	-----	\$ 1.75
1/	Service Box Old returned	{ Short $3\frac{1}{2} \times 4\frac{1}{2}$ Long $4\frac{1}{2} \times 5\frac{1}{2}$ Buff. or Rdway	-----	\$ 1.60
10.	Ft. $\frac{3}{4}$ in.	{ Copper Galv Iron Cast Iron	Pipe at 18	\$ 1.80
	Nipples	in. at	-----	\$
	Bushings	to in. at	-----	\$
	Red'g Inc'g	{ Couplings to in. at	-----	\$
	Union	in. at	-----	\$
	Meter	in. at	-----	\$
	Lead Joints at	-----		\$
	Leadite Joints at	-----		\$
	Hrs. Foreman at	-----		\$
4	Hrs. Chauffeur at	62 1/2	-----	\$ 2.50
4	Hrs. Tapper at	4	-----	\$ 2.50
7	Hrs. Labor at	45	-----	\$ 3.15
	Hrs. Labor at	-----		\$
	Hrs. Compressor at	-----		\$
	Compensation Ins.	-----		\$.25
	Trucking	-----		\$ 1.-
	Builders Use of Water	Patch	-----	\$ 5.-
	Tap by Hessel			\$
				\$
				\$
				\$ 20.86

ct.


200 - 1940

St. 214th
Pl. 9
Ave. No. 9

Stoddard

Name of Owner
Bauer

Labor and Mat'l. Report Sept 4 1940

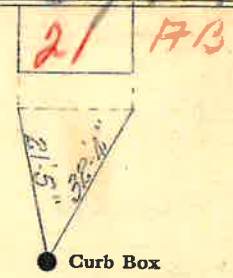

6 Main Elev. of Main at tap 54

Gate at ● Gate at ●

3/4" copper 10' to main

● Curb Box

TAX ID # 302.12-19-6