

LABOR AND MATERIALS


Copper	Lead	Connection		\$	
Curb	Cock Valve	T. S. & V.	in.	\$	
1	Service box	Short 3½ x 4½			
	Old returned	Long 4½ x 5½			
		Buff-or-Rdway		\$	
	Ft.	in.	{ Copper G. I. C. I. } Pipe at	\$	
	Nipples	in.	at	\$	
	Bushings	to	in. at	\$	
	Red'g				
	Inc'g	Coupl'gs	to in. at	\$	
	Union	in.	at	\$	
	Meter	in.	at	\$	
	Lead Joints	at		\$	
	Compound Joints	at		\$	
	Maintenance Foreman			\$	
	Hrs. Water Maint. Man-1	at		\$	
	Hrs. Water Maint. Man-2	at		\$	
	Hrs. Garage Foreman	at		\$	
	Hrs. Labor	at		\$	
	Hrs. Compressor	at		\$	
	Compensation Ins.	at \$	per C	\$	
	Trucking			\$	
	Pav't Patch			\$	
				\$	
				\$	
	O'head			\$	
				\$	

*measured in
8-6-65.*

St.
Pl.
Ave. No. 7

Name of Owner
Flood Port

Labor and Mat'l. Report 19

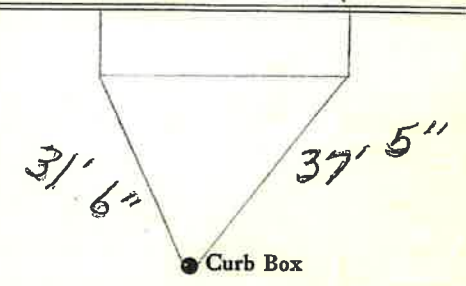

Main Elev. of
Main at tap

Gate at ● ● Gate at

Note: ● Curb Box
See #1 Dudley St.

TAX ID # 309.15-11-1