

## LABOR AND MATERIALS

Copper	Connection	3/4			\$ 2.87
Lead	Cock	3/4			
	Valve	3/4	in.		\$ 3.62
	T. S. & V.				
Service box	Short	3 1/2 X 4 1/2			
Old returned	Long	4 1/2 X 5 1/2			\$ 4.68
	Buff or Rdway				
11 Ft.	Copper	3/4	Pipe at	32	\$ 3.52
	G.I.				
	C.I.				
Nipples	in. at				\$
Bushings	to in. at				\$
Red'g					
Inc'g	Coupl'gs. to in. at				\$
Union	in. at				\$
Meter	in. at				\$
Lead Joints at					\$
Compound Joints at					\$
Hrs. Water Maint. Man-1 at					\$
4	Hrs. Water Maint. Man-2 at	1.02			\$ 4.08
1.2	Hrs. Labor— at	9.1			\$ 10.92
Hrs. Labor— at					\$
Hrs. Compressor at					\$
Compensation Ins. at \$2.18 per C.					\$ 3.3
Trucking					\$ 2.00
Pav't Patch					\$
<i>Tap by McQuinn</i>					
O'head					\$
					\$ 32.02

114

10?


St. #  
 Ph.  
 Ave. No. 6

Taylor

Name of Owner

Neron

Labor and Mat'l. Report Oct 19 1949

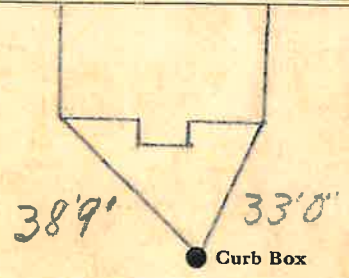

4 Main Elev. of Main at tap 5

Gate at ● Gate at ●

3/4" copper 11' to MAIN

● Curb Box

TAX ID# 309.16-5-15