


Labor and Materials

Copper } Connection.....	3	\$ 2.70
Lead }	3 1/4	\$ 2.39
Curb } Cock Valve } in.....	1	\$ 1.55
Service Box } Short 3/4 x 1 1/2 }		\$ 2.16
Old returned } Long 4 1/2 x 5 1/2 }	3 1/4	
8 Ft. } in. } Copper } Pipe at }		
Nipples.....	in. at.....	\$
Bushings.....	to..... in. at.....	\$
Red'g } Couplings.....	to..... in. at.....	\$
Inc'g }		\$
Union.....	in. at.....	\$
Meter.....	in. at.....	\$
Lbs. Br. Stone at.....		\$
Lbs. Sand at.....		\$
Bags Cement at.....		\$
Paving Brick } Mack } at.....		\$
} Red }		\$
} Asphalt }		\$
Lead Joints at.....		\$
Leadite Joints at.....		\$
7 Hrs. Foreman at.....		\$ 1.25
8 Hrs. Common Labor at.....		\$ 3.60
Hrs. Common Labor at.....		\$
Hrs Mason at.....		\$
Hrs Mason's Helper at.....		\$
Hrs. Compressor at.....		\$ 15
Compensation Ins.....		\$ 1.00
Trucking.....		\$ 5.00
Builders' Use of Water.....	Patch	\$ 5.00
Total \$		19.80

30-45 16
 Labor and Material Report May 14 1910

10 Terracotta av

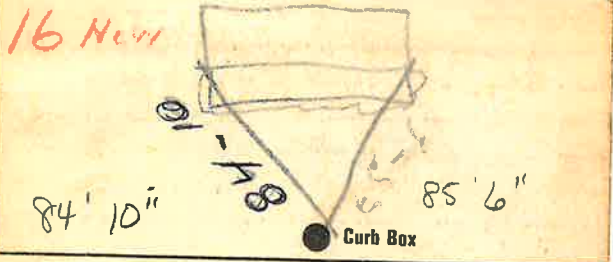

6 Main Elev of Main at top 2 1/2
 Gate at Gate at
 8' to main

Curb Box
 new house

TAX ID # 302.12.7-19