

LABOR AND MATERIALS

1	Copper Lead	Connection	3/4	\$ 2.94	
1	Curb	Cock Valve	3/4 in.	\$ 2.71	
		T. S. & V.			
1	Service box	Short 3 1/2 X 4 1/2			
	Old returned	Long 4 1/2 X 5 1/2		\$ 5.90	
		Buff or Rdway			
23	Ft.	Copper	Pipe at 30	\$ 6.90	
		G.I.			
		C.I.			
	Nipples	in. at		\$	
	Bushings	to in. at		\$	
	Red'g				
	Inc'g	Coupl'gs to in. at		\$	
	Union	in. at		\$	
	Meter	in. at		\$	
	Lead Joints	at		\$	
	Compound Joints	at		\$	
3	Hrs. Water Maint. Man—1	at 1.01		\$ 3.03	11.03
	Hrs. Water Maint. Man—2	at		\$	
10	Hrs. Labor—	at 80		\$ 8.00	
	Hrs. Labor—	at		\$	
	Hrs. Compressor	at		\$	
	Compensation Ins.	at \$ per C	24	\$ 1.00	
	Trucking			\$	
	Pav't Patch	Before Paving		\$	
	15p y. mill			\$	
	O'head			\$	
				\$ 31.72	

109

St.
Pl.
Ave. No. **23**

Terra Cotta


Name of Owner

Robert DeGraff

Labor and Mat'l. Report

July 8

1948

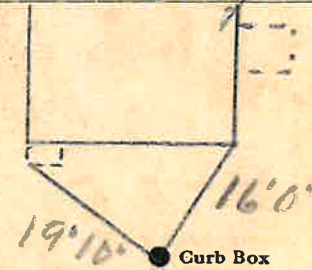

6

Main

Elev. of Main at tap

4

Gate at ●

● Gate at

3/4 copper 23' to main

● Curb Box

TAX ID# 302.12-10-7

Bill

