


26 Terracotta

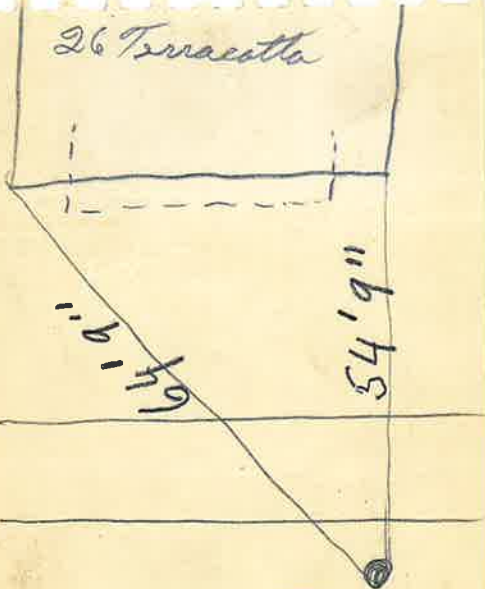

FOR LOT #25
Terracotta