

LABOR AND MATERIALS

1. Copper Lead	Connection	3/4		\$ 2.94
1. Curb	Cock Valve T-S & V.	3/4	in.	\$ 3.71
1. Service box Old returned	Short 3 1/2 X 4 1/2			\$ 5.90
	Long 4 1/2 X 5 1/2			
10 Ft. 3/4 in.	Copper Pipe at	30		\$ 3.00
Nipples	in. at			\$
Bushings	to in. at			\$
Inc'g Coupl'gs	to in. at			\$
Union	in. at			\$
Meter	in. at			\$
Lead Joints at				\$
Compound Joints at				\$
3 Hrs. Water Maint. Man-1 at		1.01		\$ 3.03
Hrs. Water Maint. Man-2 at				\$
10 Hrs. Labor - at		80		\$ 8.00
Hrs. Labor - at				\$
Hrs. Compressor at				\$
Compensation Ins. at \$	per C			\$ 2.4
Trucking				\$ 1.00
Pav't Patch	Before Paving			\$
Tax by Meter				\$
O'head				\$
				\$ 27.82

89


St.
Pl.
Ave. No. 26

Name of Owner

TerraCotta

Edgar Gallup

Labor and Mat'l. Report July 8 1948

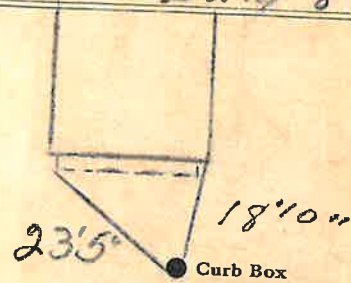

6

Main

Elev. of
Main at tap

5

Gate at ●

● Gate at

3/4" Copia

10' to main

● Curb Box

TAX ID # 302.12-7-24