

Labor and Materials

1	Copper Lead	Connection $\frac{3}{4}$	\$	1.23
1	Curb	Cock Valve T.S. & V. $\frac{3}{4}$ in	\$	1.68
1	Service Box Old returned	Short $3\frac{1}{2} \times 4\frac{1}{2}$ Long $4\frac{1}{2} \times 5\frac{1}{2}$ Buff. or Rdway	\$	1.75
24	Ft. $\frac{3}{4}$ in.	Copper Galv-Iron Cast-Iron } Pipe at .15	\$	3.60
	Nipples	in. at	\$	
	Bushings	to in. at	\$	
	Red'g Inc'g	Conplings to in. at	\$	
	Union	in. at	\$	
	Meter	in. at	\$	
	Lead Joints	at	\$	
	Leadite Joints	at	\$	
	Hrs. Foreman	at	\$	
2	Hrs. Chauffeur	at $6\frac{1}{2}$	\$	1.25
8	Hrs. Tapper	at	\$	5.00
8	Hrs. Labor	at $4\frac{1}{2}$	\$	3.60
	Hrs. Labor	at	\$	
	Hrs. Compressor	at	\$	
	Compensation Ins.		\$	30
	Tracking		\$	1.00
	Builders Use of Water		\$	
	Tap by Hassell		\$	
			\$	
			\$	
			\$	19.41

28 - 1938

S4
PT.

35-


Terra Cotta

Ave. No. 33

Name of Owner

Frank Grinnell

Labor and Mat'l. Report 5-18-38 19

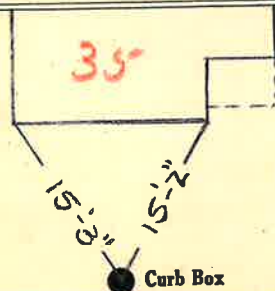

TAX ID# 302.12-10-2

6" Main Elev. of Main at tap 5

Gate at $\frac{3}{4}$ appos 24' to the main Gate at

● Curb Box

Application not paid.

dd Shutoff of main