

Labor and Materials

Lead Connection	\$
Curb Cock	\$
Service Box (Short 3 1/2 x 4)	\$
Old returned (Long 4 1/2 x 5 1/2 Buffalo)	\$
6 Ft. 1" in. G. I. Pipe at	\$
Nipples in. at	\$
Bushings to in. at	\$
Red'g Coup to in. at	\$
Inc'g Coup to in. at	\$
Union in. at	\$
Meter in. at	\$
Cu. Yds. Br. Stone at	\$
Cu. Yds. Sand at	\$
Bags Cement at	\$
Paving Brick { Mack Red Asphalt } at	\$
4 Hrs. Foreman at	\$
9 Hrs. Common Labor at	\$
Hrs. Mason at	\$
Hrs. at	\$
Hrs. at	\$
Builders' Use of Water	\$
at	\$
at	\$
at	\$
at	\$
Total	\$ 15.55

Labor and Material Report

Apr 22 1921

34 tip at 30 Terracotta Ave

36 No measurement

See below. Newcom

TAX ID# 302.12-7-28

Curb Box

Main


Elev. of Main at tap

Gate at

Gate at

6' to main

Curb Box

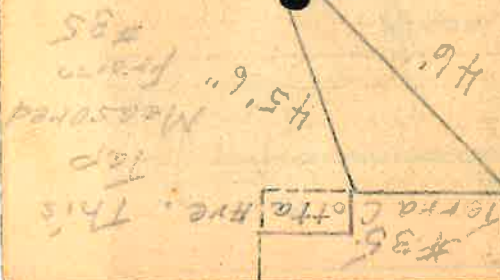

36

Labor and Material Report Apr 23 1924

at 1/4 of 80 Terra Cotta Ave

36

~~No Measurement~~

See below. New owner

TAX ID # 302.12-7-28

Curb Box

Main Elev. of Main at tap

Gate at 6' to main

#35 Terra Cotta Ave. This Tap Measured from #35.

46'

45'6"

Curb Box