

## LABOR AND MATERIALS


1	Copper	Connection	3/4		\$ 2.94
	Lead				
1	Curb	Cock Valve	3/4	in.	\$ 3.71
		T. S. & V.			
	Service box	Short	3 1/2	X 4 1/2	
	Old returned	Long	4 1/2	X 5 1/2	same \$ —
		Buff or Rdway			
10	Ft.	Copper		Pipe at	30 \$ 30.00
	3/4	G. I.			
	in.	C. I.			
	Nipples			in. at	\$
	Bushings			to in. at	\$
	Red'g				
	Inc'g	Coupl'gs		to in. at	\$
	Union			in. at	\$
	Meter			in. at	\$
	Lead Joints			at	\$
	Compound Joints			at	\$
3	Hrs.	Water Maint. Man—1	at	101	\$ 3.03
		Water Maint. Man—2	at		\$
10	Hrs.	Labor—	at	20	\$ 8.00
		Labor—	at		\$
		Compressor	at		\$
		Compensation Ins.	at \$	per C	\$ 24
		Trucking			\$ 1.00
		Pav't Patch			\$
		Tap			\$
		O'head			\$
					\$ 21.92

88

-St. \_\_\_\_\_  
-Pl. \_\_\_\_\_  
Ave. No. 40

Name of Owner  
Terra Cotta  
Kenneth Ramps

Labor and Mat'l. Report July 7 1948

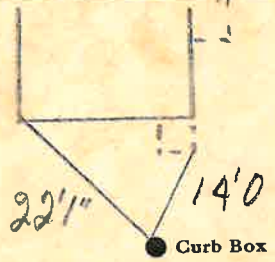

6 Main Elev. of Main at tap 5

Gate at ● ● Gate at  
3/4 copper 10' to MAIN

● Curb Box  
TAX ID # 302.12-7-29