


Labor and Materials

Copper } Connection.....	3	\$ 2.60
Lead }		
Curb } Cock }	3	\$ 2.30
Valve }		
T. Socket }		
Service Box } Short 3 1/2 x 4 1/2 }		\$ 1.50
Old returned } Long 4 1/2 x 5 1/2 }		
Buff. or Rdway }		
18 Ft. } in. } Copper } Pipe at.....		\$ 4.77
Cast Iron }		
Nipples..... in. at.....		\$
Bushings..... 2 to 1 in. at.....		\$.10
Red'g } Couplings..... to..... in. at.....		\$
Inc'g }		
Union..... in. at.....		\$
Meter..... in. at.....		\$
Lbs. Br. Stone at.....		\$
Lbs. Sand at.....		\$
Bags Cement 'at.....		\$
Paving Brick } Mack } at.....		\$
Red }		
Asphalt }		
Lead Joints at.....		\$
Leadite Joints at.....		\$
4 Hrs. Foreman at.....		\$ 2.50
12 Hrs. Common Labor at.....		\$ 4.88
Hrs. Common Labor at.....		\$
Hrs. Mason at.....		\$
Hrs. Mason's Helper at.....		\$
Hrs. Compressor at.....		\$
Compensation Ins.....		\$ 20
Trucking.....		\$ 1.00
Builders' Use of Water Patch.....		\$ 5.00
Total \$ 24.85		

29-122 9 July. 29 1929

Labor and Material Report
5 Terra. Cotta Avenue

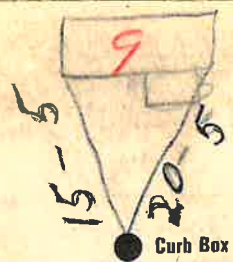

6 Main Elev of Main at tap 5.2
Gate at 3/4" Copper Gate at 18' to main

● Curb Box
old Tap Disconnected

TAX ID# 302.12-10-13