


Labor and Materials

Copper	{	Connection.....	\$
Lead			
Curb	{	Cock Valve	} in \$
		T. S. & V.	
Service Box	{	Short 3 1/2 x 4 1/2	} \$
Old returned		Long 4 1/2 x 5 1/2	
		Buff. or Rdway	
Ft. in.	{	Copper	} Pipe at \$
		Galv Iron	
		Cast Iron	
Nipples		in. at	\$
Bushings		to in. at	\$
Red'g	{	Conplings.....	to in. at \$
Inc'g			
Union		in. at	\$
Meter		in. at	\$
Lead Joints		at	\$
Leadite Joints		at	\$
Hrs. Foreman		at	\$
Hrs. Chauffeur		at	\$
Hrs. Tapper		at	\$
Hrs. Labor		at	\$
Hrs. Labor		at	\$
Hrs. Compressor		at	\$
Compensation Ins.			\$
Trucking			\$
Builders Use of Water			\$
			\$
			\$
St. //
~~Pt.~~
 Terra Costa Ave. No. // 7

Name of Owner
 Maxvelli

75-22
 Labor and Mat'l. Report 7-5-27 19

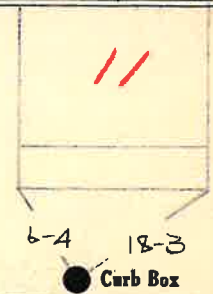

TAX ID# 302.12-10-12

Elev. of
 Main at tap.....

Main Gate at • Gate at

● Curb Box