

Labor and Materials

Lead Connection	\$
Curb Cock	\$
Service Box (Sheet 2) at	\$
Old returned } Long 4 1/2 x 5 1/2	\$
10 Ft. 2 in. G. I. Pipe at	\$
Nipples.....in. at	\$
Bushings.....to.....in. at	\$
Red'g Coup.....to.....in. at	\$
Inc'g Coup.....to.....in. at	\$
Union.....in. at	\$
Meter.....in. at	\$
Cu. Yds. Br. Stone at	\$
Cu. Yds. Sand at	\$
Bags Cement at	\$
Paving Brick { Mack Red Asphalt } at	\$
4 Hrs. Foreman at	\$
12 Hrs. Common Labor at	\$
Hrs. Mason at	\$
Hrs. at	\$
Hrs. at	\$
Builders' Use of Water	\$
..... at	\$
..... at	\$
..... at	\$
..... at	\$
Total	\$ 14.98	


Labor and Material Report

12

July 9

1925

3/4" Tap at No 8 from Patten

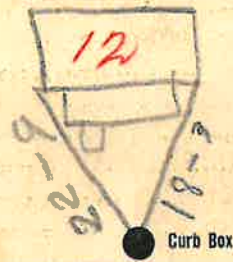

6 Main Elev. of Main at tap 5

Gate at 3/4" LEAD 10' to main Gate at



TAX ID# 302.12.7-18