

LABOR AND MATERIALS

1.	Copper	Connection	$\frac{3}{4}$		\$ 2.94
	Lead				
1.	Curb	Cock Valve	$\frac{3}{4}$	in.	\$ 3.71
		T. S. & V.			
	Service box	Short $3\frac{1}{2} \times 4\frac{1}{2}$	} Same. \rightarrow		
	Old returned	Long $4\frac{1}{2} \times 5\frac{1}{2}$			
23.	Ft.	$\frac{3}{4}$ in.	Copper	Pipe at	30 \$ 6.90
			C.I.		
	Nipples	in. at			\$
	Bushings	to in. at			\$
	Inc'g	Coupl'gs to in. at			\$
	Union	in. at			\$
	Meter	in. at			\$
	Lead Joints	at			\$
	Compound Joints	at			\$
3.	Hrs.	Water Maint. Man-1	at	1.01	\$ 3.03
	Hrs.	Water Maint. Man-2	at		\$
1.0.	Hrs.	Labor	at	80	\$ 8.00
	Hrs.	Labor	at		\$
	Hrs.	Compressor	at		\$
	Compensation Ins.	at \$	per C	24	\$ 1.20
	Trucking				\$
	Pav't Patch	Before Paving			\$
	Tap by Miller				\$
	O'head				\$
					\$ 25.82


104

St.
Pl.
Ave. No. 13

Terra Cotta

Name of Owner
Mrs Edna Everts

Labor and Mat'l. Report July 7 1948

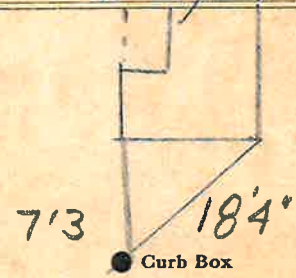

6 Main Elev. of Main at tap 5

Gate at ● ● Gate at

$\frac{3}{4}$ " copper 23' to main

● Curb Box

TAX ID # 302.12-10-11

LSM-5C 5 15-48

To be Charge ✓