

LABOR AND MATERIALS

1	Copper Lead	Connection	3/4		\$ 2.94
1	Curb	Cock Valve	3/4	in.	\$ 3.71
		T. S. & v.			
	Service box	Short 3 1/2 X 4 1/2			
	Old returned	Long 4 1/2 X 5 1/2	Same		
		Buff or Rdway			
22	Ft.	Copper	3/4	in.	\$ 6.60
		C.I.		Pipe at 30	
	Nipples			in. at	\$
	Bushings			to in. at	\$
	Red'g				
	Inc'g	Coupl'gs		to in. at	\$
	Union			in. at	\$
	Meter			in. at	\$
	Lead Joints				\$
	Compound Joints				\$
1.0	Hrs. Water Maint. Man—1		1.01		\$ 2.03
	Hrs. Water Maint. Man—2				\$
1.0	Hrs. Labor—		8.0		\$ 8.00
	Hrs. Labor—				\$
	Hrs. Compressor				\$
	Compensation Ins.			at \$ per C	\$ 2.4
	Trucking				\$ 1.00
	Pav't Patch				\$
	Tap by Mill				\$
	O'head				\$
					\$ 25.52

106

St.
 Pl.
 Ave. No. 15


Terra Cotta

Name of Owner

Eugenia Maynard

Labor and Mat'l. Report

July 7 1948

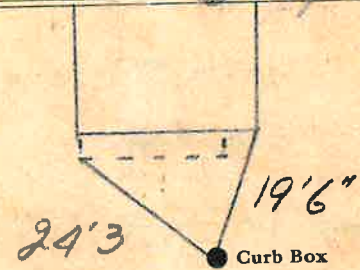

6 Main

Elev. of Main at tap 5

Gate at ●

● Gate at

3/4" Copper 22' to MAIN

● Curb Box

TAX ID# 302.12-10-10

Take Charge ✓