


95-26

Labor and Material Report Oct 22 1926

147 Third St 3/4 Top
Contract

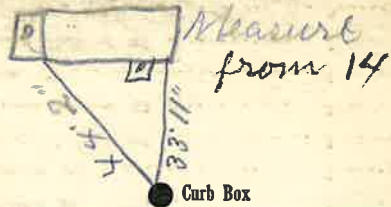

6" Main

Elev. of Main at tap 4 1/2

Gate at ●

● Gate at

● Curb Box

Old tap shut off

H.W.

REAR OF PROPERTY

THIRD

St.


●

Ave. No. 14 1/2

Name of Owner

Labor and Mat'l. Report

19

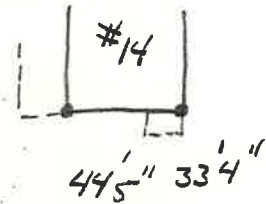

● Curb Box

Main

Elev. of Main at tap

Gate at ●

● Gate at

3/4 copper 23' to main

● Curb Box

TIES TAKEN FROM #14

- JULY '00

