


LABOR AND MATERIALS

1	Copper	Connection	$\frac{3}{4}$	\$
1	Lead			\$
1	Curb	Cock Valve	$\frac{3}{4}$ in.	\$
		T.S. & V.		\$
1	Service box	Short $3\frac{1}{2} \times 4\frac{1}{2}$		\$
	Old returned	Long $4\frac{1}{2} \times 5\frac{1}{2}$		\$
		Buff or Rdway		\$
22 Ft. 6 in.		Copper	Pipe at $\frac{3}{4}$ "	\$
		G.I.		\$
		C.I.		\$
	Nipples	in. at		\$
	Bushings	to in. at		\$
	Red'g			\$
	Inc'g	Coupl'gs to in. at		\$
	Union	in. at		\$
	Meter	in. at		\$
	Lead Joints	at		\$
	Compound Joints	at		\$
	Maintenance Foreman			\$
	Hrs. Water Maint. Man-1	at		\$
	Hrs. Water Maint. Man-2	at		\$
	Hrs. Garage Foreman	at		\$
	Hrs. Labor	at		\$
	Hrs. Compressor	at		\$
	Compensation Ins.	at \$ per C		\$
	Trucking			\$
	Pav't Patch			\$
				\$
				\$
	O'head			\$
				\$

St. Third
~~Pt.~~
 Ave. No. 16

Name of Owner
Charles Maurer

Labor and Mat'l. Report August 31 1978

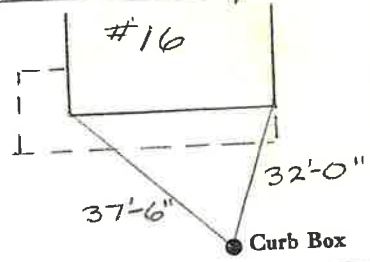

Main Elev. of Main at tap 5'

Gate at • • Gate at
 $\frac{3}{4}$ copper 22'6" to main

• Curb Box

TAX ID # 309.12-13-11