

### LABOR AND MATERIALS


Copper } Connection _____	\$ _____
Lead } _____	\$ _____
Curb } Cock Valve } _____ in. _____	\$ _____
} T. S. & V. } _____	\$ _____
Service box } Short 3½ x 4½	} _____ \$ _____
Old returned } Long 4½ x 5½	
} Buff or Rdway	
10 Ft. 6 in. } Copper } Pipe at _____	\$ _____
} G. I. } _____	\$ _____
} C. I. } _____	\$ _____
Nipples _____ in. at _____	\$ _____
Bushings _____ to _____ in. at _____	\$ _____
Red'g } Coupl'gs _____ to _____ in. at _____	\$ _____
Inc'g } _____	\$ _____
Union _____ in. at _____	\$ _____
Meter _____ in. at _____	\$ _____
Lead Joints at _____	\$ _____
Compound Joints at _____	\$ _____
Maintenance Foreman _____	\$ _____
Hrs. Water Maint. Man-1 at _____	\$ _____
Hrs. Water Maint. Man-2 at _____	\$ _____
Hrs. Garage Foreman _____ at _____	\$ _____
Hrs. Labor _____ at _____	\$ _____
Hrs. Compressor at _____	\$ _____
Compensation Ins. at \$ _____ per C _____	\$ _____
Trucking _____	\$ _____
Pav't Patch _____	\$ _____
_____	\$ _____
_____	\$ _____
O'head _____	\$ _____
_____	\$ _____

St. \_\_\_\_\_  
~~Pl.~~ No. 17  
 Ave. No. \_\_\_\_\_

THIRD

Name of Owner \_\_\_\_\_  
Patch

Labor and Mat'l. Report JUNE 1984

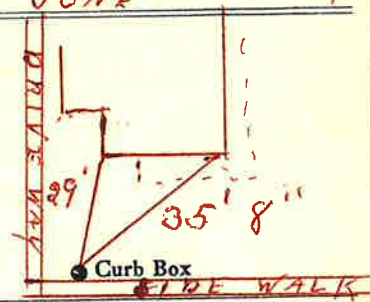

Main \_\_\_\_\_ Elev. of Main at tap \_\_\_\_\_

Gate at • \_\_\_\_\_ Gate at \_\_\_\_\_

10'6" to main

next to

• Curb Box

TAX ID# 309.12-10-36