


Labor and Materials

1	Copper	Connection	3/4	\$ 3.20
1	Curb	Cock T-S & V.	in. 1/2	\$ 1.00
1	Service Box	Short 3/4x4 1/2		\$ 1.30
	Old returned	Long 1 1/2x5 1/2 Buff. or Rdway		
23	Ft.	Copper Galv. Iron Cast Iron	Pipe at 1/2	\$ 506
	Nipples	in. at		\$
	Bushings	to in. at		\$
	Red'g Inc'g	Couplings	to in. at	\$
	Union	in. at		\$
	Meter	in. at		\$
	Lbs. Br. Stone	at		\$
	Lbs. Sand	at		\$
	Bags Cement	at		\$
	Paving Brick	Mack Red Asphalt	at	\$
	Lead Joints	at		\$
	Leadite Joints	at		\$
2	Hrs. Foreman	at		\$ 1.25
17	Hrs. Common Labor	at		\$ 6.91
	Hrs. Common Labor	at		\$
	Hrs. Mason	at		\$
	Hrs. Mason's Helper	at		\$
2	Hrs. Compressor	at		\$ 3.00
	Compensation Ins.			\$ 2.2
	Trucking			\$ 1.00
	Builders' Use of Water			\$
Total \$				229.4

27-178
Labor and Material Report

Dec 11 1928

12¹⁰ Third St

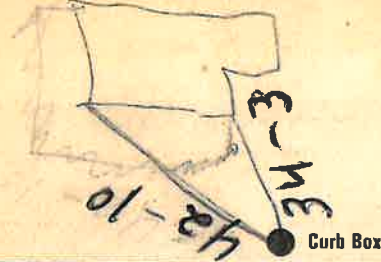

E Main

Elev of Main at tap 5 1/2

Gate at 23' to MAIN

Gate at

Curb Box

Old Tap Short off

TAX ID# 309.12-13-12