

LABOR AND MATERIALS

1	Copper lead	{ Connection	-----	\$ 1.23
1	Curb	{ Cock Valve T.S. & V. } $\frac{3}{4}$ in.	-----	\$ 1.68
	Service Box Old returned	{ Short $3\frac{1}{2} \times 4\frac{1}{2}$ Long $4\frac{1}{2} \times 5\frac{1}{2}$ Buff. or Rdway }	-----	\$
9	Ft. $\frac{3}{4}$ in.	{ Copper Galv. Iron Cast Iron } Pipe at	7	\$ 1.53
	Nipples	in. at	-----	\$
	Bushings	to in. at	-----	\$
	Red'g Inc'g	{ Couplings to in. at	-----	\$
	Union	in. at	-----	\$
	Meter	in. at	-----	\$
	Lead Joints	at	-----	\$
	Leadite Joints	at	-----	\$
	Hrs. Foreman	at	-----	\$
4	Hrs. Chauffeur	at 6 1/2 hr	-----	\$ 2.50
4	Hrs. Tapper	at	-----	\$ 2.50
6	Hrs. Labor	at 45	-----	\$ 2.70
	Hrs. Labor	at	-----	\$
	Hrs. Compressor	at	-----	\$
	Compensation Ins.		-----	\$ 24
	Trucking		-----	\$ 1
	Builders Use of Water	no patch	-----	\$
	Tap by Nessel		-----	\$
			-----	\$
			-----	\$
			-----	\$
			-----	\$
			-----	\$ 13.38

92 -- 1939

St.

Pl.

Ave. No. 21


Third

Name of Owner

Scott Jones

Labor and Mat'l. Report

Sept 7 1939

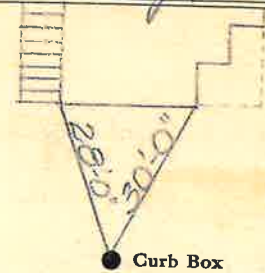

6 Main

Elev. of Main at tap 57

Gate at ●

● Gate at

$\frac{3}{4}$ " COPPER

9' to MAIN

● Curb Box

To be Billed

TAX ID# 309.12-10 34

old Tap shot off