


LABOR AND MATERIALS

1	Copper Lead	Connection	3/4"	\$
1	Curb	Cock or rise	1 3/4 in.	\$
		Valve		
		T.S. & V.		
1	Service box	Short 3 1/2 x 4 1/2		
	Old returned	Long 4 1/2 x 5 1/2		
		Buff or Rdway		\$
24	Ft.	Copper	3/4 in.	
		C.I.		
		C.I.		
		Pipe at		\$
	Nipples	in. at		\$
	Bushings	to in. at		\$
	Red'g Inc'g	Coupl'gs. to in. at		\$
	Union	in. at		\$
	Meter	in. at		\$
	Lead Joints at			\$
	Compound Joints at			\$
	Maintenance Foreman			\$
	Hrs. Water Maint. Man-1 at			\$
	Hrs. Water Maint. Man-2 at			\$
	Hrs. Garage Foreman at			\$
	Hrs. Labor at			\$
	Hrs. Compressor at			\$
	Compensation Ins. at \$	per C		\$
	Trucking			\$
	Pay't Patch			\$
	Tap made April 22-65			\$
	By G. S. Ford & Co.			\$
	O'head			\$
				\$

Third St. St. -Pl. Ave. No. 30

Name of Owner
Roger Gordon

Labor and Mat'l. Report April 22 1965

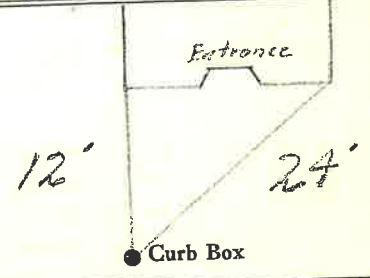

6" Main Elev. of Main at tap 5'

Gate at • Gate at

3/4" copper 24' to MAIN

• Curb Box

TAX ID# 309.12-13-17