

LABOR AND MATERIALS

1 Copper Lead } Connection $3/4$ \$ 1.35

1 Curb } Cock Valve } $3/4$ in. \$ 1.80
 } T.S. & V. }

1 Service Box } Short $3\frac{1}{2} \times 4\frac{1}{2}$ }
 Old returned } Long $4\frac{1}{2} \times 5\frac{1}{2}$ }
 } Buff for Rdway } \$ 1.70

10 Ft. $3/4$ in. } Copper }
 } Galv-Iron } Pipe at 18 \$ 1.80
 } Cast-Iron }

..... Nipples..... in. at \$

..... Bushings to in. at \$

..... Red'g } Couplings to in. at \$
 Inc'g }

..... Union..... in. at \$

..... Meter..... in. at \$

..... Lead Joints at \$

..... Leadite Joints at \$

..... Hrs. Foreman at \$

3 Hrs. Chauffeur at $6.7 hr$ \$ 1.88

6 Hrs. Tapper at \$ 3.75

6 Hrs. Labor at 4.5 \$ 2.70

..... Hrs. Labor at \$

..... Hrs. Compressor at \$

..... Compensation Ins. \$ 26

..... Trucking \$ 1

..... Builders Use of Water $1/2 Patel (Sanwa)$ \$ 2.50

.....
 Tapp & Hassel

\$ 18.94


3 1941'

Third

St.
 Pl. No. 31
 Ave. No. 31

Name of Owner
 McCarthy

Labor and Mat'l. Report Jan 7 19-41

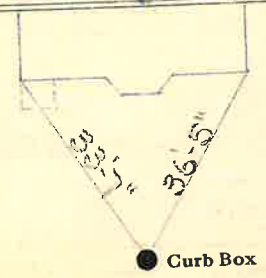

6 Main

Elev. of
 Main at tap. 5'

Gate at Gate at

$3/4$ " copper . 10' to MAIN

● Curb Box

TAX ID# 309.12-10-29