


LABOR AND MATERIALS

1 Copper } Connection 3/4" \$  
 Lead }  
 1 Curb } Cock } 3/4" or seal. \$  
           } Valve }  
           } T. S. & V. }  
 1 Service box } Short 3 1/2 x 4 1/2 }  
 Old returned } Long 4 1/2 x 5 1/2 }  
                   } Buff or Rdway } \$  
 15 Ft. 3/4" } Copper } Pipe at \$  
                   } G. I. }  
                   } C. I. }  
 Nipples..... in. at..... \$  
 Bushings..... to..... in. at..... \$  
 Red'g }  
 Inc'g } Coupl'gs..... to..... in. at..... \$  
 Union..... in. at..... \$  
 Meter..... in. at..... \$  
 Lead Joints at..... \$  
 Compound Joints at..... \$  
 Maintenance Foreman..... \$  
 Hrs. Water Maint. Man—1 at..... \$  
 Hrs. Water Maint. Man—2 at..... \$  
 Hrs. Garage Foreman..... at..... \$  
 Hrs. Labor..... at..... \$  
 Hrs. Compressor at..... \$  
 Compensation Ins. at \$..... per C..... \$  
 Trucking..... \$  
 Pav't Patch..... \$  
 pay by Warrant \$  
+ H&Bshi. \$  
 O'head 8-31-66. \$  
 \$

Third St. Pl. Ave. No. 33

Name of Owner  
Geo. L. Emery

Labor and Mat'l. Report Aug. 31 1966

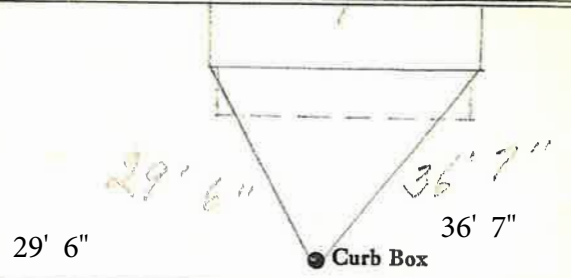

6" Main Elev. of Main at tap 4'

Gate at ● Gate at ●  
3/4" copper 15' to MAIN

● Curb Box

TAX ID # 309.12.10-28