


Labor and Materials

Copper } Connection.....	3	\$ 2.60
Lead }	1/4	
Curb } Cock	3	\$ 2.30
Value }		
P.S. & V. }	4	
Service Box } Short 3/4 x 1/2		\$ 1.40
Old returned } Long 4/8 x 5/8		
	Buff. or Rdway	
20 Ft. 3/4 in. } Copper		\$ 5.30
	Galv. Iron	
	Cast Iron	
Nipples.....	in. at.....	\$.....
Bushings.....	to..... in. at.....	\$.....
Red'g } Couplings.....	to..... in. at.....	\$.....
Inc'g }		
Union.....	in. at.....	\$.....
Meter.....	in. at.....	\$.....
Lbs. Br. Stone at.....		\$.....
Lbs. Sand at.....		\$.....
Bags Cement 'at.....		\$.....
Paving Brick } Mack		\$.....
	Red	
	Asphalt	
Lead Joints at.....		\$.....
Leadite Joints at.....		\$.....
3 Hrs. Foreman at.....		\$ 1.88
2.4 Hrs. Common Labor at.....		\$ 9.75
Hrs. Common Labor at.....		\$.....
Hrs. Mason at.....		\$.....
Hrs. Mason's Helper at.....		\$.....
Hrs. Compressor at.....		\$.....
Compensation Ins.....		\$.31
Trucking.....		\$ 1.00
Builders' Use of Water.....		\$ 5.00
Total \$		29.54

Labor and Material Report

11 - 23 1930

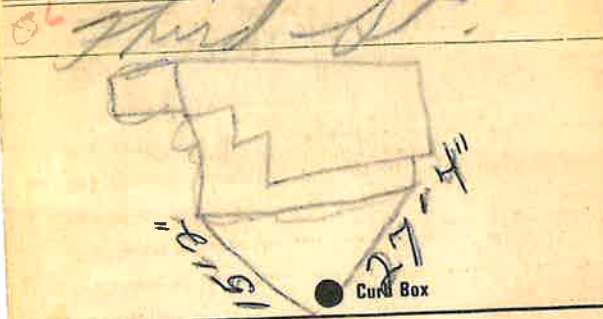

6 Main Elev of Main at tap 5

Gate at 3/4" copper Gate at 20' to MAIN

● Curb Box

old pipe disconnected

TAX ID # 309.12-13-6