


LABOR AND MATERIALS

1	Copper Lead	Connection	3/4	\$	2.94
1	Curb	{ Clock Valve { T.S. & V. }	3/4 in.	\$	3.71
1	Service box Old returned	{ Short 3 1/2 X 4 1/2 { Long 4 1/2 X 5 1/2 { Buff or Rdway }		\$	5.90
23	Ft.	3/4 in.	{ Copper Galv. Iron { Cast Iron }	Pipe at 30	\$ 6.90
	Nipples	in. at		\$	
	Bushings	to in. at		\$	
1	Red'g In'g	Couplings	X to 3/4 in. at	\$.18
	Union	in. at		\$	
	Meter	in. at		\$	
	Lead Joints at			\$	
	Compound Joints at			\$	
5	Hrs. Foreman at			\$	
	Hrs. Chauffeur at	W.M.M. ✓	91	\$	4.55
	Hrs. Tapper at			\$	
1.2	Hrs. Labor at		80	\$	9.60
	Hrs. Labor at			\$	
1	Hrs. Compressor at		1.20	\$	1.20
	Compensation Ins.			\$	31
	Trucking			\$	1.00
	Builders Use of Water			\$	10.70
	Supply Materials			\$	
				\$	
				\$	
				\$	
				\$	
				\$	46.99

St. Third St
Pl. 42
Ave. No. 42

Name of Owner Dufour

Labor and Mat'l. Report Apr 29 19 48

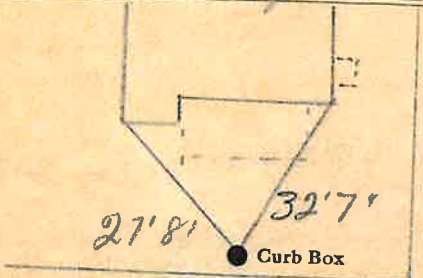

Big Cross St

4 Main Elev. of Main at tap 6

Gate at ● Gate at ●
3/4" copper 23' to main

● Curb Box

TAX ID # 309.11-11-2

Tap on Big Cross St ✓