


Labor and Materials

1	Copper	Connection	3/4"	\$
1	Lead			\$
1	Curb	Cock	3/4" in	\$
		Valve		
		T. S. & V.		
1	Service Box	Short 3 1/2 x 4 1/2	}	\$
	Old returned	Long 4 1/2 x 5 1/2		
		Buff. or Rdway		
18	Ft. 3/4 in.	Copper	} Pipe at	\$
		Galv Iron		
		Cast Iron		
	Nipples	in. at		\$
	Bushings	to in. at		\$
	Red'g	} Couplings	to in. at	\$
	Inc'g			
	Union	in. at		\$
	Meter	in. at		\$
	Lead Joints	at		\$
	Leadite Joints	at		\$
	Hrs. Foreman	at		\$
	Hrs. Chauffeur	at		\$
	Hrs. Tapper	at		\$
	Hrs. Labor	at		\$
	Hrs. Labor	at		\$
	Hrs. Compressor	at		\$
	Compensation Ins.			\$
	Trucking			\$
	Builders Use of Water			\$
	Tap by Gifford & Co.			\$
	10-29-68			\$

St. Third
 Pt. 46
 Ave. No. 46

Name of Owner Oudekerk

Labor and Mat'l. Report Oct. 29 1968

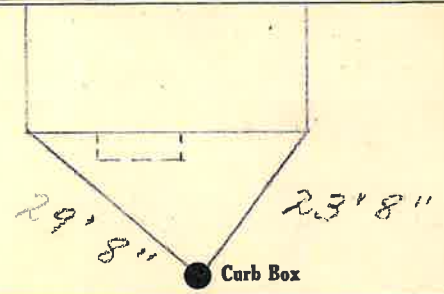

TAX ID# 309.11-11-4
 4" Main Elev. of Main at tap 4'

Gate at 3/4" copper Gate at 8' to main

● Curb Box

Tap made Due to
 leak between
 main Curb box.