

Labor and Materials


Copper	Lead	Connection	\$ 2.60
Curb	Cock Valve	T. S. & V.	\$ 2.27
Service Box	Short 3 1/2 x 4 1/2	Long 4 1/2 x 5 1/2	\$ 1.38
Old returned	Buff or Rdway		
17 Ft.	Copper	Galv. Iron	Pipe at \$ 3.06
Nipples	in. at		\$
Bushings	to in. at		\$
Red'g Inc'g	Couplings	to in. at	\$
Union	in. at		\$
Meter	in. at		\$
Lbs. Br. Stone	at		\$
Lbs. Sand	at		\$
Bags Cement	at		\$
Paving Brick	Mack Red Asphalt	at	\$
Lead Joints	at		\$
Leadite Joints	at		\$
2 Hrs.	Foreman	at	\$ 1.25
16 Hrs.	Common Labor	at	\$ 7.20
Hrs.	Common Labor	at	\$
Hrs.	Mason	at	\$
Hrs.	Mason's Helper	at	\$
Hrs.	Compressor	at	\$
Compensation	Ins.		\$.26
Trucking			\$ 1.00
Builders' Use of Water	Potal		\$ 5.00
Total \$			24.02

31-94

Labor and Material Report

10 1931

48 Third St

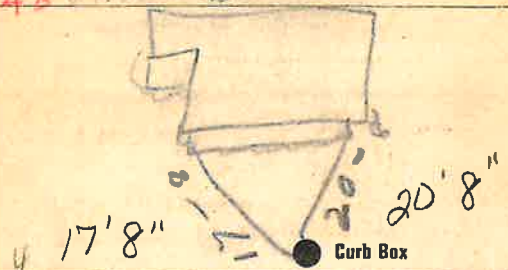

4 Main Elev of Main at tap 5
 Gate at 3/4" copper 17' to main Gate at

● Curb Box
 Old tap shut off
 TAX ID# 309.11-11-5