

Labor and Materials


Copper	} Connection.....	3	\$. 1.75
Lead			
Curb	} Cock Valve T.S.&V. }	3	\$. 1.70
Service Box	} Short 3 1/2 x 4 1/2 Long 4 1/2 x 5 1/2 Buff. on Edgew. }	1	\$. 1.45
Old returned			
22 Ft. 3/4 in.	} Copper Galv. Iron Cast Iron }		\$. 2.97
Pipe at			
Nipples	in. at		\$.
Bushings	to in. at		\$.
Red'g Inc'g	} Couplings.....to.....in.at..... }		\$.
Union	in. at		\$.
Meter	in. at		\$.
Lbs. Br. Stone	at		\$.
Lbs. Sand	at		\$.
Bags Cement	at		\$.
Paving Brick	} Mack Red Asphalt }		\$.
Lead Joints	at		\$.
Leadite Joints	at		\$.
3 Hrs. Foreman	at 6 1/2		\$. 1.88
Hrs. Common Labor	at		\$.
Hrs. Common Labor	at		\$.
Hrs. Mason	at		\$.
Hrs. Masons Helper	at		\$.
Hrs. Compressor	at		\$.
Compensation Ins			\$. .87
Trucking			\$. 1.-
Builders Use of Water	Patch		\$. 5.-
Total			\$. 15.32

1935-74

Labor and Material Report

June 28 1935

Across from 567 Third St

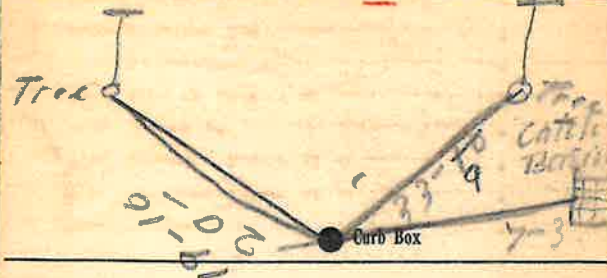

4 Main Elev. of Main at tap 4

Gate at 3/4" copper Gate at 22' to main

● Curb Box

New tap for Kings grounds Third St.