

LABOR AND MATERIALS

1	Copper Lead	{ Connection	3/4		\$ 1.35
1	Curb	{ Cock Valve T. S. & V.	3/4	in.	\$ 1.88
1	Service Box Old returned	{ Short 3 1/2 x 4 1/2 Long 4 1/2 x 5 1/2 Buff. or Rdway			\$ 1.82
16	Ft.	3/4 in.	{ Copper Galv Iron Cast Iron	Pipe at 20	\$ 3.20
	Nipples	in. at			\$
	Bushings	to in. at			\$
	Red'g Inc'g	{ Couplings	to in. at		\$
	Union	in. at			\$
	Meter	in. at			\$
	Lead Joints	at			\$
	Leadite Joints	at			\$
	Hrs. Foreman	at			\$
6	Hrs. Chauffeur	at	.68 2/4		\$ 4.13
3	Hrs. Tapper	at	"		\$ 2.06
4	Hrs. Labor	at	.55		\$ 2.20
	Hrs. Labor	at			\$
	Hrs. Compressor	at			\$
	Compensation Ins.				\$ 26
	Trucking				\$ 1.-
	Builders Use of Water	Patch			\$ 5.00
		Tap 4 Hessel.			\$
					\$
					\$
					\$
					\$
					\$ 22.90

H.

Chapter 30 nrf

19 1942

St.

Pl.


Ave. No. 58

Name of Owner

Douglas

Labor and Mat'l. Report

May 15 1942

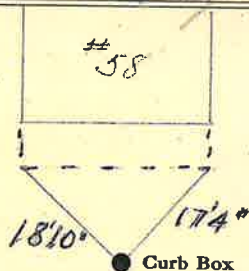

4 Main

Elev. of Main at tap 4'

Gate at ● Gate at ●

3/4" Copper 16' to main

● Curb Box

TAX ID# 309.11-11-10

278

H.